



Republic of the Philippines
Benguet State University

2601 La Trinidad, Benguet
www.bsu.edu.ph

Telefax No. (074) 661-1839; Email:procurement@bsu.edu.ph

REQUEST FOR QUOTATION (RFQ)
(ALL ENTRIES ARE MANDATORY)

Name of Owner/ Corporation/ Cooperativel Agency: _____

QUOTATION NO. 668

Name of Business : _____

DATE: APR 21 2026

Address: _____

P.R. NO. : 2026-02-BTI-92

Email address: _____ Telephone No. _____

ABC: Php. 210,000.00

FUND SOURCE: BTI

The Benguet State University through its Bids and Awards Committee will undertake SYP for the item/s listed below under the following terms and conditions:

- All entries must be written legibly and accurately.
- Delivery period is within 15 calendar days.
- Warranty period shall be for a minimum of three months, in case of expendable supplies, and a minimum of one year in case of non- expendable supplies from date of acceptance by the University.
- Price validity shall be for a period of 45 calendar days.
- Compliance with specifications: Kindly specify in the column provided below whether the offer fully complies with the specifications or a counter offer.
- Deadline of submission of quotation is on or before 5:00 PM of April 28, 2026. Offers may be submitted in sealed or open quotation in person, or through facsimile (074-661-1839) or email (procurement@bsu.edu.ph)**
- The item/s shall be procured by: a) line item; b) lot; c) sub-lot
- Business Permit Number : _____, date of issue: _____, place of issue: _____
(If renewal of Business Permit is still on process, please indicate OR No: _____, date of OR : _____ for the payment of renewal).
- * PhilGEPS Registration Number: _____

JOSEL M. FLORENTIN
Chairperson, BAC (Goods & Services)
[Signature]
MAR 26 2026

College/Dept./Office: **BSU FOOD PROCESSING CENTER**

Item No.	Qty	Unit	Item	Technical Specifications (Brand and Model)		ABC	Unit Cost	Total Cost
				COMPLY	COUNTER OFFER			
1	1	LOT	Supplies and materials, delivery and installation of CCTV & Accessories			210,000.00		
			Atleast 8TB CCTV Hard Drive					
			2 pcs Outdoor Dome CCTV Camera with atleast 8MP with night vision; full color with audio					
			9 pcs Indoor 8MP Full Color Bullet IP Camera with audio					
			1 SET: 16 channels recorder Network Video Recorder inclusive of other materials (port switch, PoE ports, etc);					
			1 set of atleast 43" android TV with full motion wall mount bracket (tilt & swivel)					
			1 lot Cable management materials inclusive of Accessories (as applicable) PVC Moldings, PVC/EMT Pipes, junction boxes, connectors, adaptors, 9U Network Cabinet					
			Labor & Installation, electricals, testing and configuration					
			TOTAL			210,000.00		
			XXXXXXXXXX					

Counter offers:


Delivery Period: _____
Warranty: _____
Price Validity: _____

We hereby submit our quotations, accept the general conditions for the above items and be bound by our offer.

Signature over Printed Name

Date and Time of Receipt of RFQ

* not a ground for disqualification for failure to indicate but required as a condition for award.

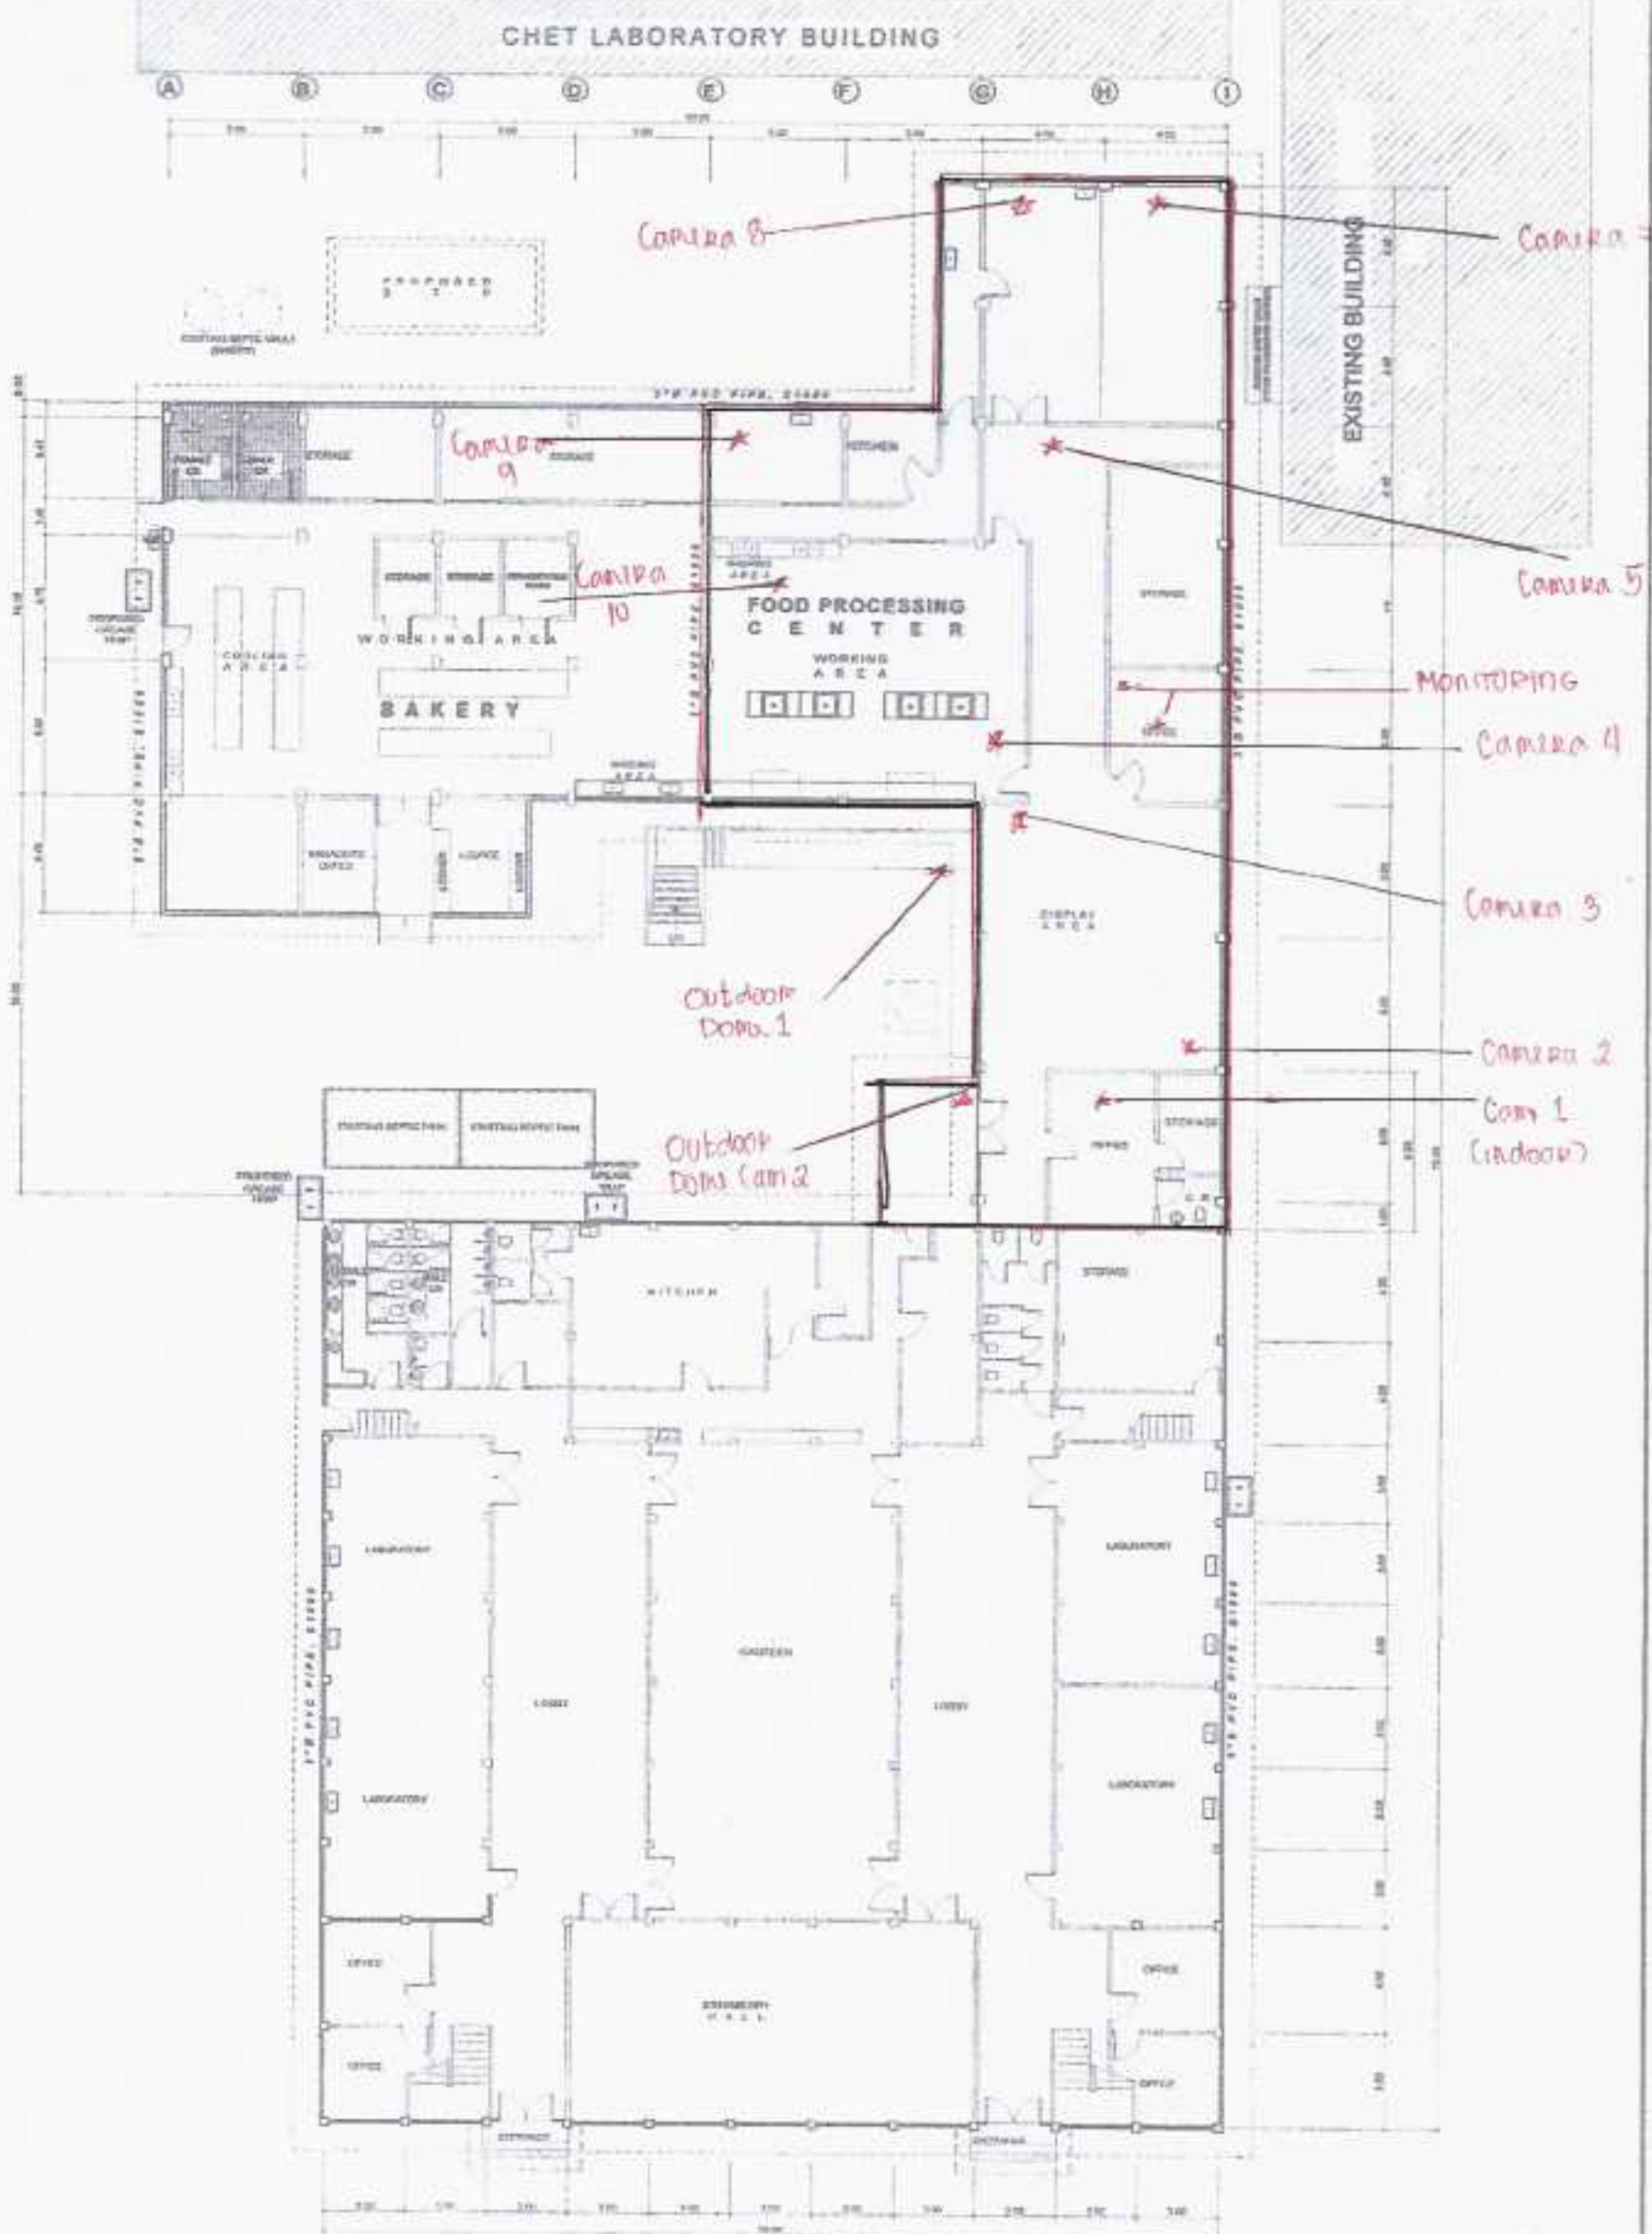

FLOORPLAN (BAKERY, FOOD PROCESSING AND RSDC)
SCALE 1:250 MTS

 HAZENYEN, RIBANGAY PRC REG. No. 02840 PTR No.	PRC REG. No. PTR No.	BAKERY, FOOD PROCESSING AND RSDC FLOORPLAN "As-built Plan"	OWNER VP-ADMINISTRATION PRESIDENT	SHEET CONTENTS	ISSUED
				REVISION/DATE	ISSUED
ARCHITECT	ENGINEER	PROJECT TITLE			EMS 95-1-15